
# EVENING BREEZE SUBDIVISION, FILING NO.2

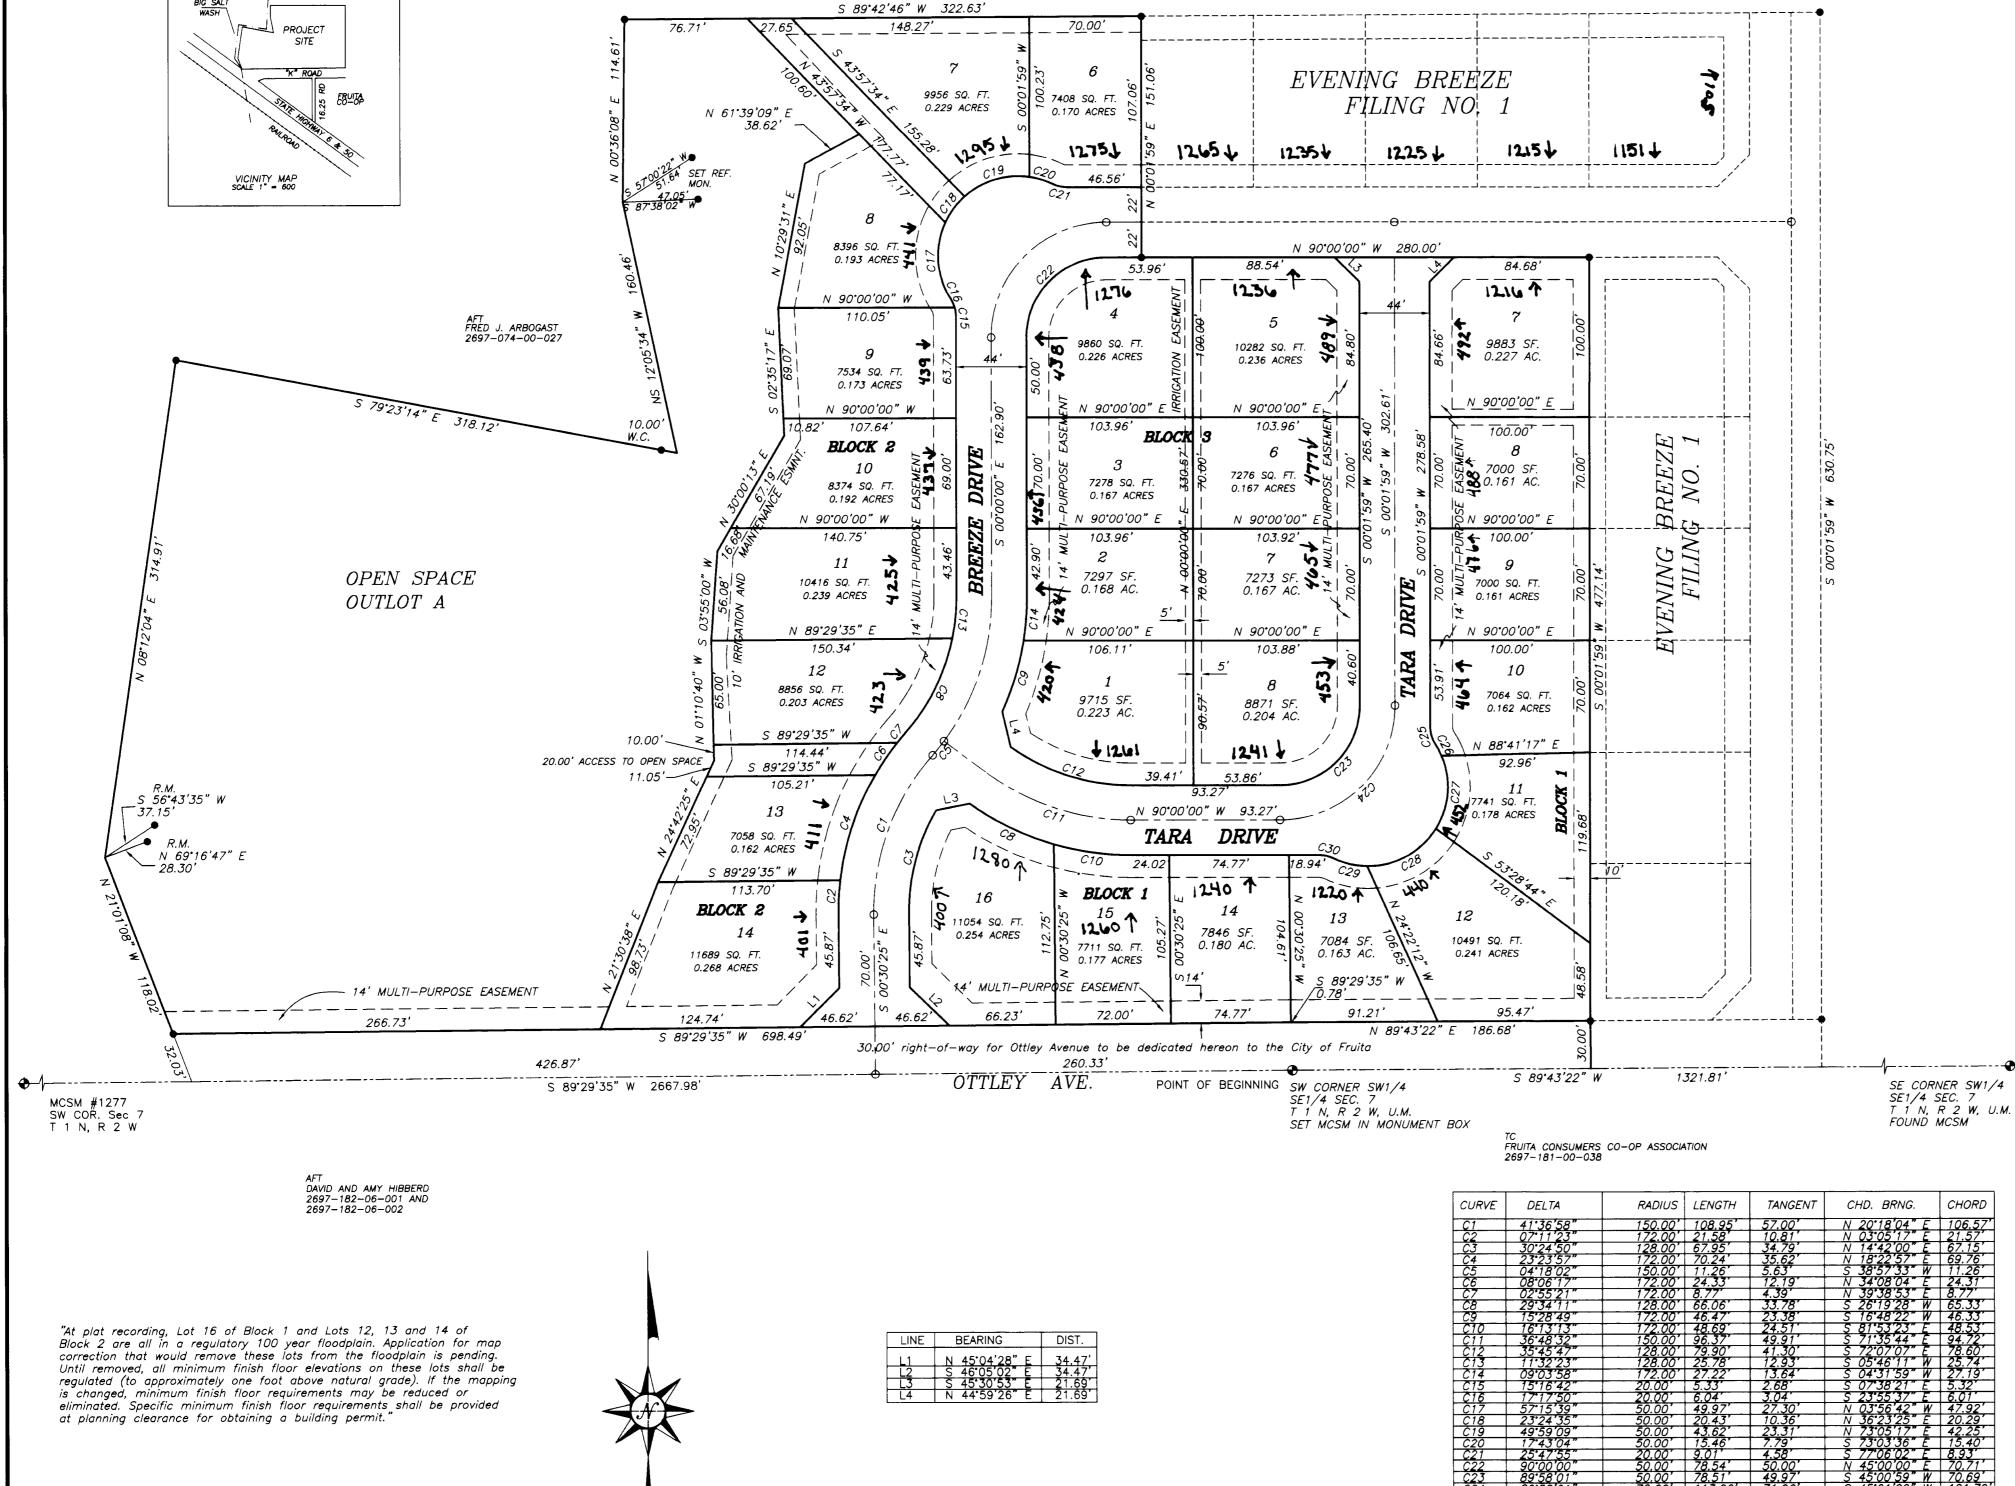

<u>LEGEND</u> ● MESA COUNTY OR BLM SURVEY MARKER

2" ALUMINUM CAP, LS 24953, ON No. 5 REBAR IN CONCRETE

SET CITY OF FRUITA CENTERLINE MONUMENT

◆ 2.5" ALUMINUM CAP ON No.6 REBAR

PLASTIC CAP ON No. 5 REBAR TO BE SET UPON COMPLETION OF CONSTRUCTION, AT ALL LOT CORNERS

CURVE	DELTA	RADIUS	LENGTH	TANGENT	CHD. BRNG.	CHORD
C1	41.36.58"	150.00	108.95	57.00'	N 20°18'04" E	106.57
C2	07'11'23"	172.00	21.58	10.81	N 03.05,17" E	21.57
C3	30°24'50"	128.00	67.95	34.79'	N 14°42'00" E	67.15
C4	23°23'57"	172.00	70.24	35.62'	N 18'22'57" E	69.76
<u>C5</u>	04'18'02"	150.00	11.26	5.63'	S 38.57'33" W	11.26
C6	<u>08</u> *06′17″	172.00	24.33	12.19	N 34°08'04" E	24.31
<i>C7</i>	02'55'21"	172.00′	8.77	4.39'	N 39°38′53″ E	8.77
C8	29'34'11"	128.00	66.06'	33.78	S 26'19'28" W	65.33
C9	15'28'49"	172.00	46.47	23.38'	S 16'48'22" W	46.33
C10	16'13'13"	172.00	48.69	24.51	S 81 53'23" E	48.53
C11	<i>36</i> °48'32"	150.00°	96.37	49.91	S 71°35′44″ E	94.72
C12	<u>35°45'47"</u>	128.00'	79.90'	41.30'	S 72*07′07″ E	78.60'
<u>C13</u>	11'32'23"	128.00'	<i>25.78</i> ′	12.93'	S 05°46'11" W	25.74
C14	09'03'58"	172.00	27.22	13.64'	S 04'31'59" W	27.19
C15	15'16'42"	20.00	5.33'	2.68'	S 07°38′21″ E	5.32
C16	17'17'50"	20.00	6.04	3.04	S 23°55′37″ E	6.01
C17	<i>57</i> *15'39"	50.00'	49.97	27.30'	N 03°56'42" W	47.92
C18	23*24'35"	50.00'	20.43	10.36'	N 36°23′25″ E	20.29
C19	49*59'09"	50.00'	43.62	23.31	N 73°05′17″ E	42.25
C20	17.43'04"	50.00	15.46	7.79'	S 73'03'36" E	15.40
C21	<i>25</i> °47′55″	20.00	9.01	4.58'	S 77'06'02" E	8.93
C22	90'00'00"	50.00	78.54	50.00	N 45.00'00" E	70.71
C23	89.58'01"	50.00'	78.51	49.97	S 45.00'59" W	70.69
C24	89.58'01"	72.00'	113.06	71.96	S 45°01'00" W	101.79
C25	32'34'32"	20.00'	11.37	5.84	N 16.15,17" W	11.22
C26	09'39'05"	50.00'	8.42'	4.22'	S 27.43'01" E	8.41
C27	55°00'17"	50.00'	48.00	26.03'	S 04°36'40" W	46.18
C28	58°32'18"	50.00'	51.08'	28.02	N 61°22'58" E	48.89
C29	25.12.23"	50.00'	22.00'	11.18'	S 76 44 42" E	21.82
C30	25°51'30"	20.00	9.03	4.59	S 77°04'15" E	8.95

Basis of bearings assume the South line of the SE1/4 SW 1/4 of Section 7 to bear N 89°43'22" E 1321.81 feet. Monuments on this line are as shown on the accompanying plat.

Easement and title documents (schedules A&B) provided by Abstract & Title Company of Mesa County policy No. 900389, dated November 20, 1998.

Existing property corners which were recovered during this survey which were within 0.25 feet  $\pm$  of the calculated position were accepted as being "in position".

#### CERTIFICATE OF DEDICATION AND OWNERSHIP

I, Raymond L. Oellrich, the sole owner in fee simple of all that real property described as follows:

Commencing at the SW corner SW1/4 SE1/4 of Section 7, T 1 N, R 2 W, Ute P.M., whence the SE corner of said SW1/4 SE1/4 bears N 89°43'22" E a distance of 1321.81 feet for a basis of bearings with all bearings contained herein relative thereto; thence S 89°43'22" E a distance of 186.67 feet; thence N 00°01'59" E a distance of 30.00 feet to aa point on the North right—of—way of Ottley Avenue and the Point of Beginning. Thence N 00°01'22" E a distance of 477.14 feet; thence N 90°00'00" W a distance of 280.00 feet; thence N 00°01'59" E a distance of 151.06 feet; thence S 89°42'46" W a distance of 322.63 feet; thence S 00°36′08" W a distance of 114.61 feet; thence S 12°05'34" E a distance of 160.46 feet; thence N 79°23'14" W a distance of 318.12 feet; thence S 08°12'04" W a distance of 314.91 feet; thence S 21°01'08" E a distance of 118.02 feet; thence N 89°29'35" E a distance of 698.48 feet to the Point of Beginning. Containing 10.46 acres as described.

Have by these presents laid out, platted and subdivided the same into lots and blocks as shown on this plat and designate the same as the EVENING BREEZE SUBDIVISION, FILING NO.2 in the City of Fruita, County of Mesa, State of Colorado; and do hereby grant, convey, dedicate and set apart to the City of Fruita, County of Mesa, Colorado, for public use all the streets shown hereon, including avenues, drives, courts, places and alleys, the public lands shown hereon for utility and drainage purposes only. We hereby accept the responsibilty for the completion of required public improvements for the EVENING BREEZE SUBDIVISION, FILING NO.2 and further, hereby grant the right to install and maintain all necessary structures to the entity responsible for providing services for which the easements are established. We further state that this subdivision shall be subject to the protective covenants filed and recorded for this subdivision in the offices of the Clerk and Recorder of Mesa County, in Book\_2585 at Page\_80\_\_\_\_.

EXECUTED this 18 day of February. 2000.

STATE OF COLORADO COUNTY OF MESA ss

The foregoing instrument was acknowledged before me by Raymond L. Oellrich this 18 1 day of February, A.D., #2000

Witness my hand and official seal

# CITY COUNCIL CERTIFICATE

public dedications shown hereon; subject to the provision that approval in no way obligates the City of Fruita for financing or construction of improvements on said lands, streets or easements dedicated to the public except as specifically agreed to by the City Council of the City of Fruita. Further, said approval in no way obligates the City of Fruita for manitenance of public improvements until construction of said improvements has been completed in accordance with the City of Fruita's specifications and the City of Fruita has agreed to accept said improvements. This approval does not guarantee that the size, soil cinditions, sub—surface geology, ground water conditions, or flooding conditions of any of any lot shown hereon are such that building permit, development permit, or any other required permit will be issued. This approval is with the understanding that all expenses involving required improvements for all utility services, paving, grading, landscaping, curbs, gutters, sidewalks, road lighting, road signs, flood protection devices, drainage structures, and all other improvements that may be required shall be the responsibility of the owners designated hereon and not the City of Fruita, unless otherwise specifically agreed to in writing by the Board of Trustees.

Witness my hand and seal of the City of Fruita, Colorado

## CLERK AND RECORDER'S CERTIFICATE

STATE OF COLORADO COUNTY OF MESA ss

I hereby certify that this instrument was filed in my office at 8:47 o'clock A .M., February 25, A.D., 2000, 

1940090 Reception No.

## SURVEYOR'S CERTIFICATION

I, Jeffrey C. Fletcher, do hereby certify that I am a registered land surveyor licensed under the laws of the State of Colorado, that this plat is a true correct, and complete plat of the Evening Breeze Subdivision, Filing No.2 as laid out, platted, dedicated and shown hereon, that such plat was made from an accurate survey of said property by me and under my supervision and correctly shows the location and dimensions of the lots, staked upon the ground in compliance with the Title 39, Article 51, C.R.Ş., as amended, and all other regulations governing the subdivision of land.

EXECUTED this 17 TH day of JANVARY , 2000

Prepared for: Raymond L. Oellrich 1530 Hall Ave. Grand Junction, CO 81501

> CENTURY SURVEYING P.O. BOX 356, GRAND JCT., CO 81501 970-241-2667

EVENING BREEZE SUB. FILING NO.2 A PART OF THE S1/2 OF SEC. 7, T1N, R2W. UTE MERIDIAN, CITY OF FRUITA, MESA COUNTY, COLORADO

SHEET 1 OF 1

NOTICE: ACCORDING TO COLORADO LAW YOU MUST COMMENCE ANY LEGAL

STREETS

TOTAL

ACTION BASED UPON ANY DEFECT IN THIS SURVEY WITHIN THREE YEARS AFTER YOU FIRST DISCOVER SUCH DEFECT. IN NO EVENT, MAY ANY ACTION BASED UPON ANY DEFECT IN THIS SURVEY BE COMMENCED MORE THAN TEN YEARS FROM THE DATE OF CERTIFICATION SHOWN HEREON.

AREA SUMMARY

= 3.78 Acres

= 2.90 Acres

= 10.46 Acres

3.78 Acres

36.21%

36.16%

27.63%

100.00%

SCALE: 1"=60'